


V6

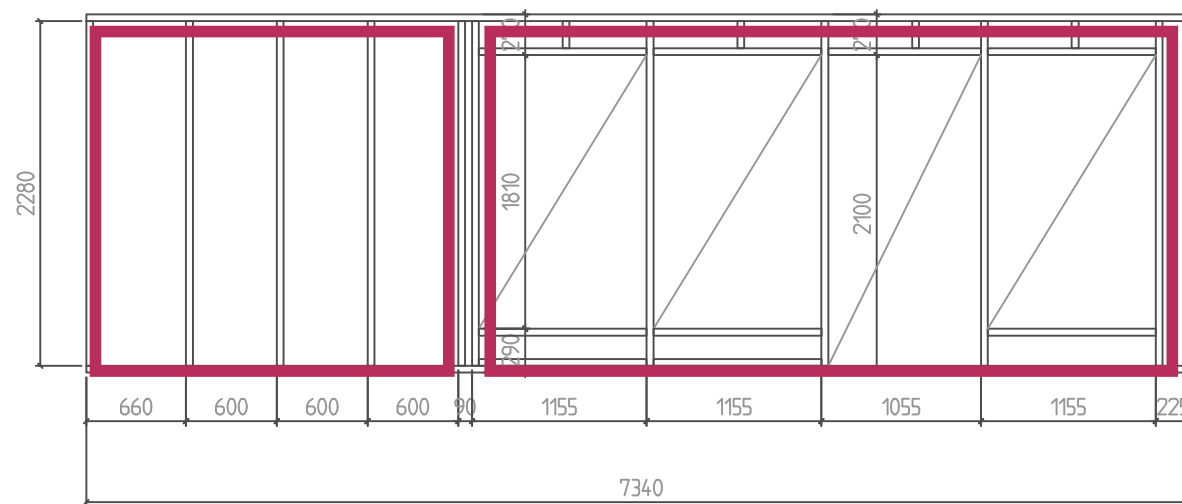

V5

BET	INT	INVERSNOM AVSÖR	DATEM	SKRI
STATUS				
RELATIONSHANDLINGAR				
PROJEKT				
SILJANSNÄS				
ARBET	REDAKORREKTURAV		HANDELAGGARE	
	MHN		MHN	
DATEM	AREVISOR			
130405				
NYBYGGNAD FRITIDSHUS				
ELEVATIONER V05-V06				
SKALA	RETELMÄNNEN		BET	
1: 50		K20.4-103		